




AS-BUILT DRAWINGS

HISTORIC HOUSE OF SEVEN GABLES

HERITAGE VILLAGE

11909 125th Street, Largo, Florida 33774

For: Pinellas County, Florida

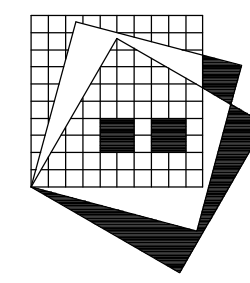

RENKER · EICH · PARKS ARCHITECTS

LIC. AA C001447 1609 Dr. Martin Luther King Jr. Street North St. Petersburg, Florida 33704-4203 (727-821-2986)

REPA PROJECT NO.: 2126.03

ARCHITECT

RENKER EICH PARKS ARCHITECTS

1609 DR MARTIN LUTHER KING JR ST NORTH
ST. PETERSBURG, FLORIDA 33704

INDEX


COVER SHEET

ARCHITECTURAL

A-1 FIRST FLOOR PLAN
A-2 SECOND FLOOR PLAN
A-3 ROOF PLAN
A-4 ELEVATIONS
A-5 ELEVATIONS

DATE: January 31st, 2023

H:\2021\2126.03 HV Seven Gables - As-Built\Drawings\2126.03 Seven Gables First Floor Plan Sheet.aec
2/7/2023 2:37 PM

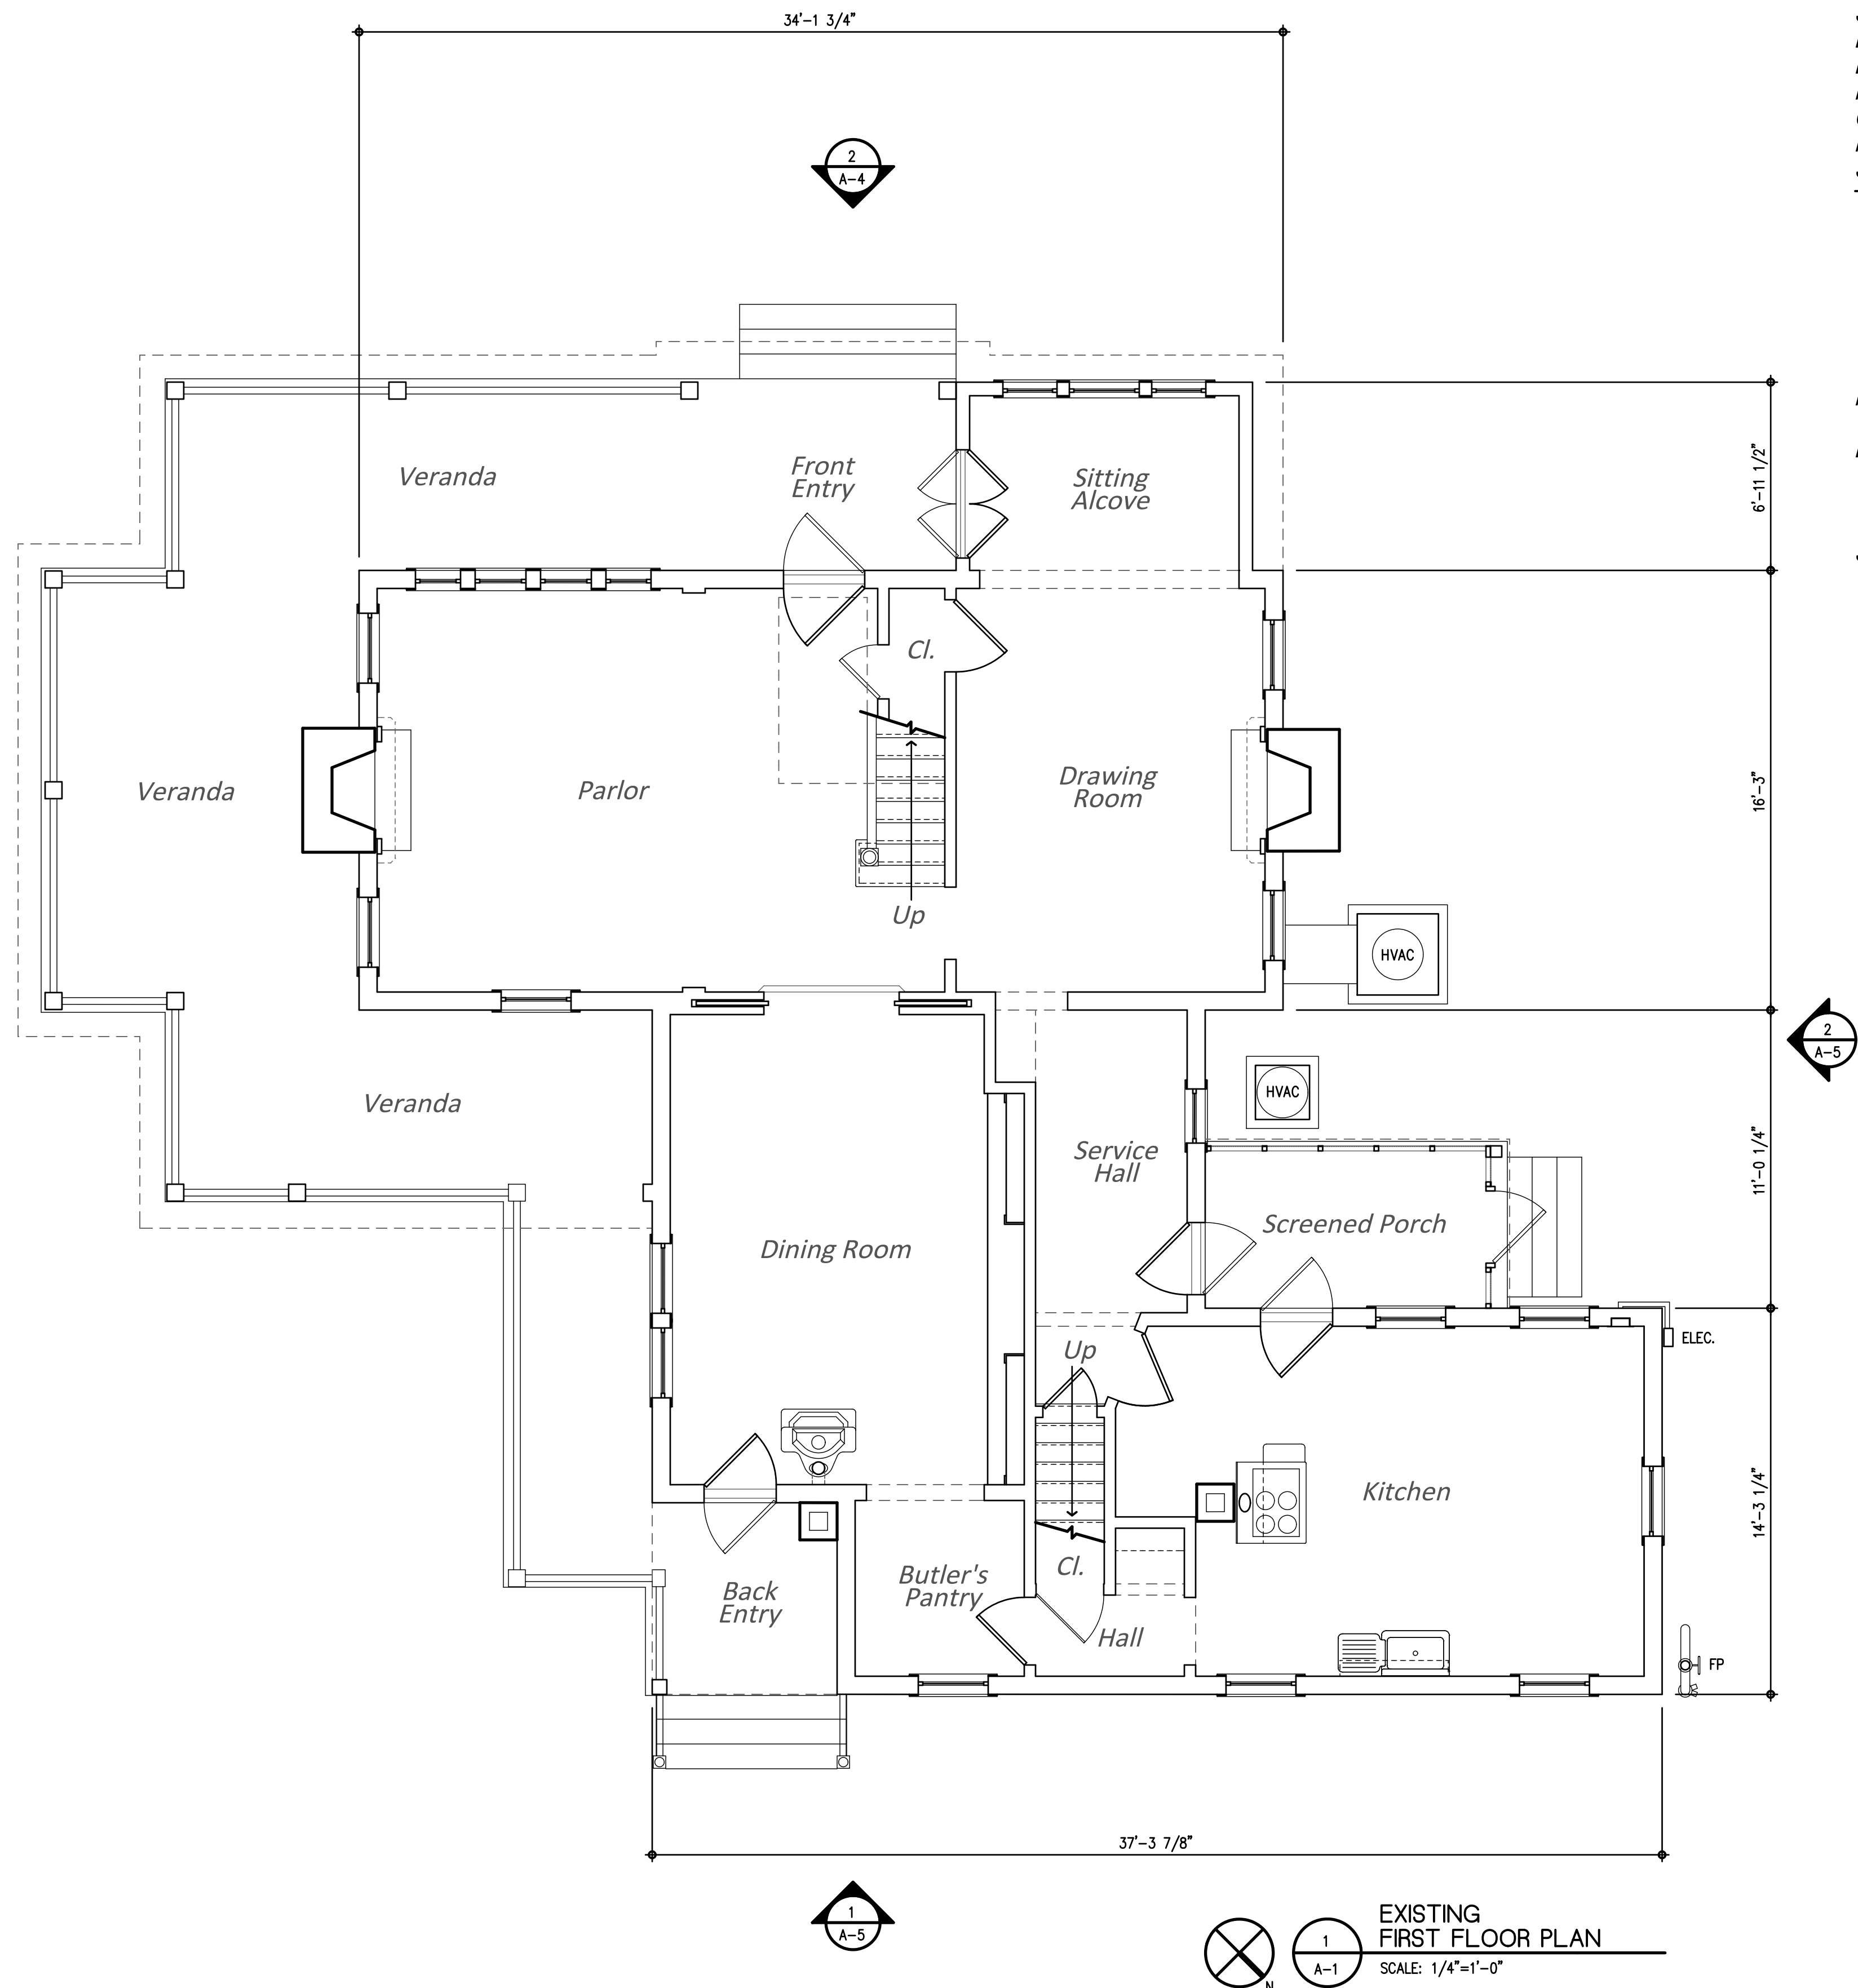

EXISTING FIRST FLOOR PLAN
SCALE: 1/4"=1'-0"

Interior Areas (Net SF)	
Parlor	300
Drawing Room	170
Closet	11
Sitting Alcove	64
Dining Room	223
Butlers Pantry	40
Hall	16
Closet	5
Kitchen	233
Service Hall	78
Total First Floor	1,140 Net SF
Total First Floor	1,342 Gross SF
Front Porch	64 Net SF
Back Porch	44 Net SF
Veranda	457 Net SF
Screened Porch	60 Net SF

NOT FOR CONSTRUCTION

As-Built CAD Drawings
HISTORIC HOUSE OF SEVEN GABLES
11909 125th Street North, Largo, Florida 33774
Pinellas County
400 S. Ft. Harrison, Clearwater, Florida 33756


PROJECT NO.: 2126.03
DATE: 01/31/2023
DRAWN BY: PCP
REVISIONS:

SHEET TITLE:
FIRST FLOOR PLAN

SHEET NO.:
A-1
OF SHEETS



RENKER · EICH · PARKS ARCHITECTS
1609 Dr. Martin Luther King Jr. Street North • St. Petersburg, Florida • 33704-4203 • (727-881-2986)
LIC. AA 0001447

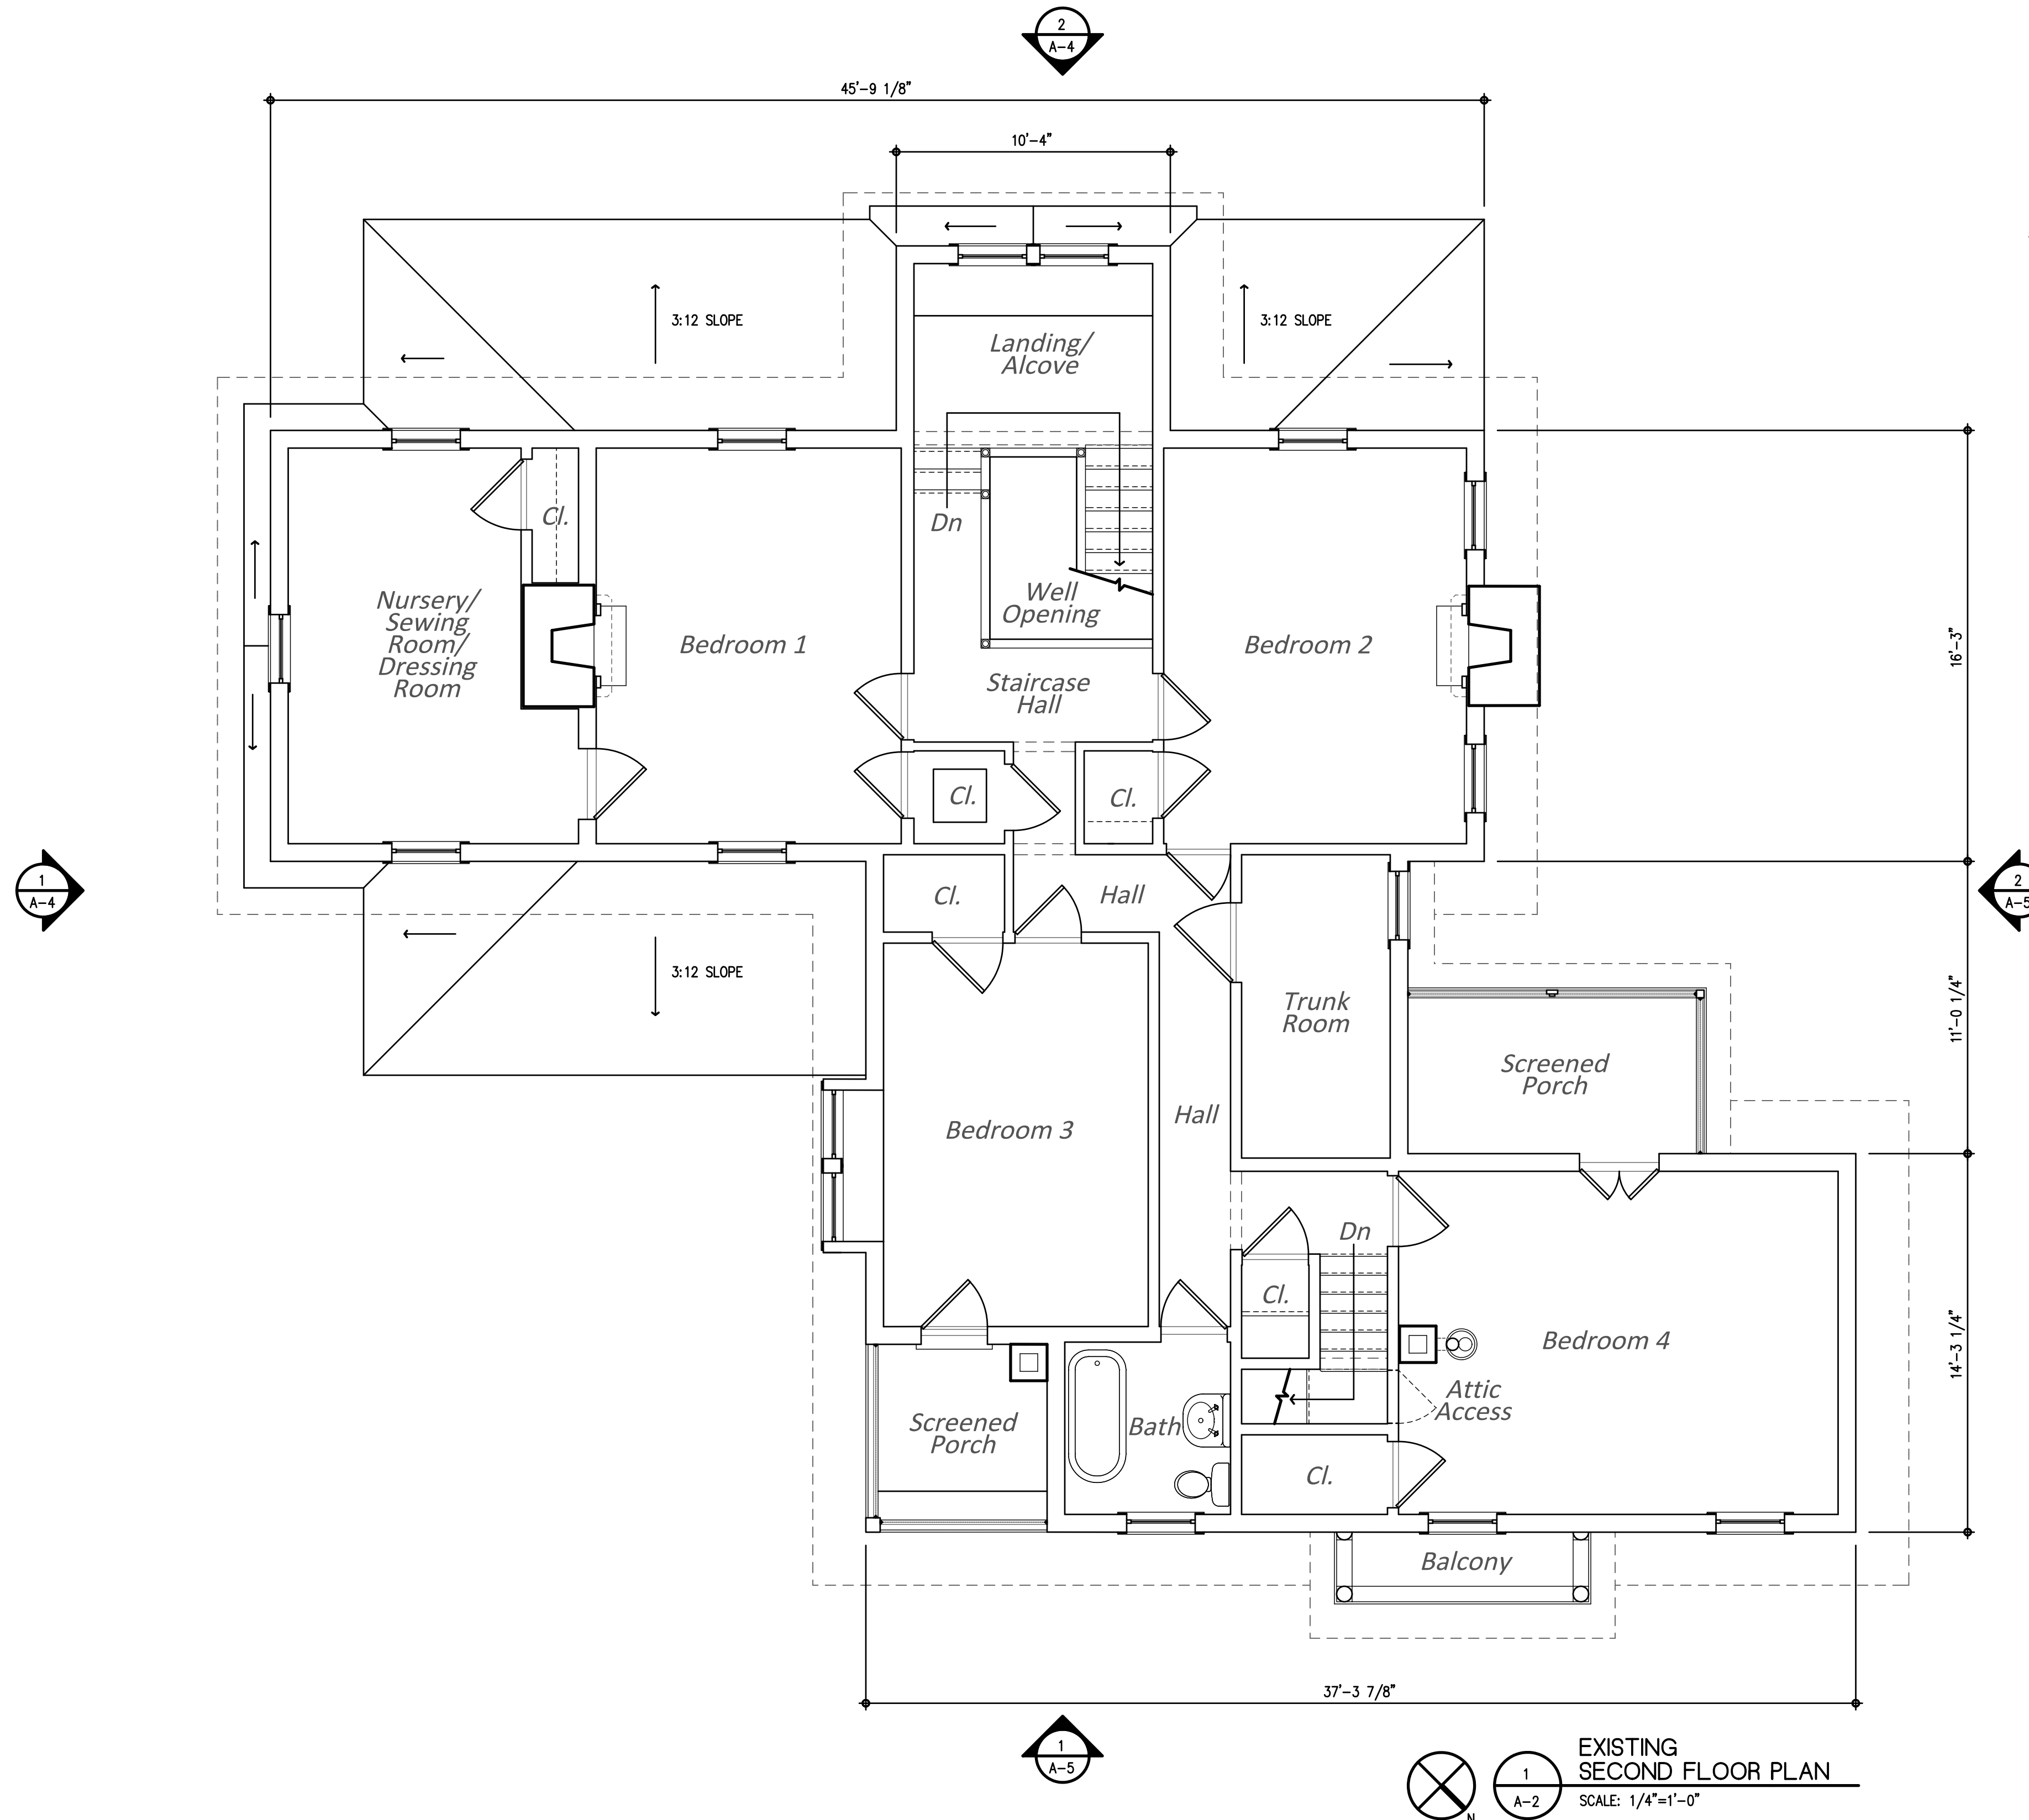

EXISTING
SECOND FLOOR PLAN
SCALE: 1/4"=1'-0"

Interior Areas (Net SF)

Landing/Alcove	62
Well Opening	44
Staircase Hall	50
Bedroom 1	171
B1 Closet	11
Nursery	142
Nurs. Closet	9
Bedroom 2	170
B2 Closet	9
Bedroom 3	152
B3 Closet	13
Hall	91
Trunk Room	64
Bathroom	40
Hall Closet	9
Bedroom 4	214
B4 Closet	16

Total Second Floor 1,267 Net SF

Total Second Floor 1,537 Gross SF

B3 Screened Porch 40 SF

B4 Screened Porch 64 SF

B4 Balcony 17 SF

NOT FOR CONSTRUCTION

As-Built CAD Drawings
HISTORIC HOUSE OF SEVEN GABLES
11909 125th Street North, Largo, Florida 33774

Pinellas County
400 S. Ft. Harrison, Clearwater, Florida 33756


PROJECT NO.: 2126.03
DATE: 01/31/2023
DRAWN BY: PCP
REVISIONS:

SHEET TITLE:
SECOND FLOOR PLAN

SHEET NO.:

A-2


OF SHEETS

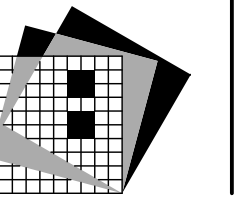

RENKER · EICH · PARKS ARCHITECTS
1609 Dr. Martin Luther King Jr. Street North • St. Petersburg, Florida • 33704-4203 • (727-881-2986)
LIC. AA 0001447

H:\2021\2126.03 HV Seven Gables - As-Built\Drawings\2126.03 Seven Gables Roof Sheet.dwg
2/7/2023 1:15 PM

Roof Areas (Net SF)		
Upper Roofs	2,016 Net SF	20.16 Squares
Lower Roofs	580 Net SF	5.80 Squares
Total	2,596 Net SF	25.96 Squares

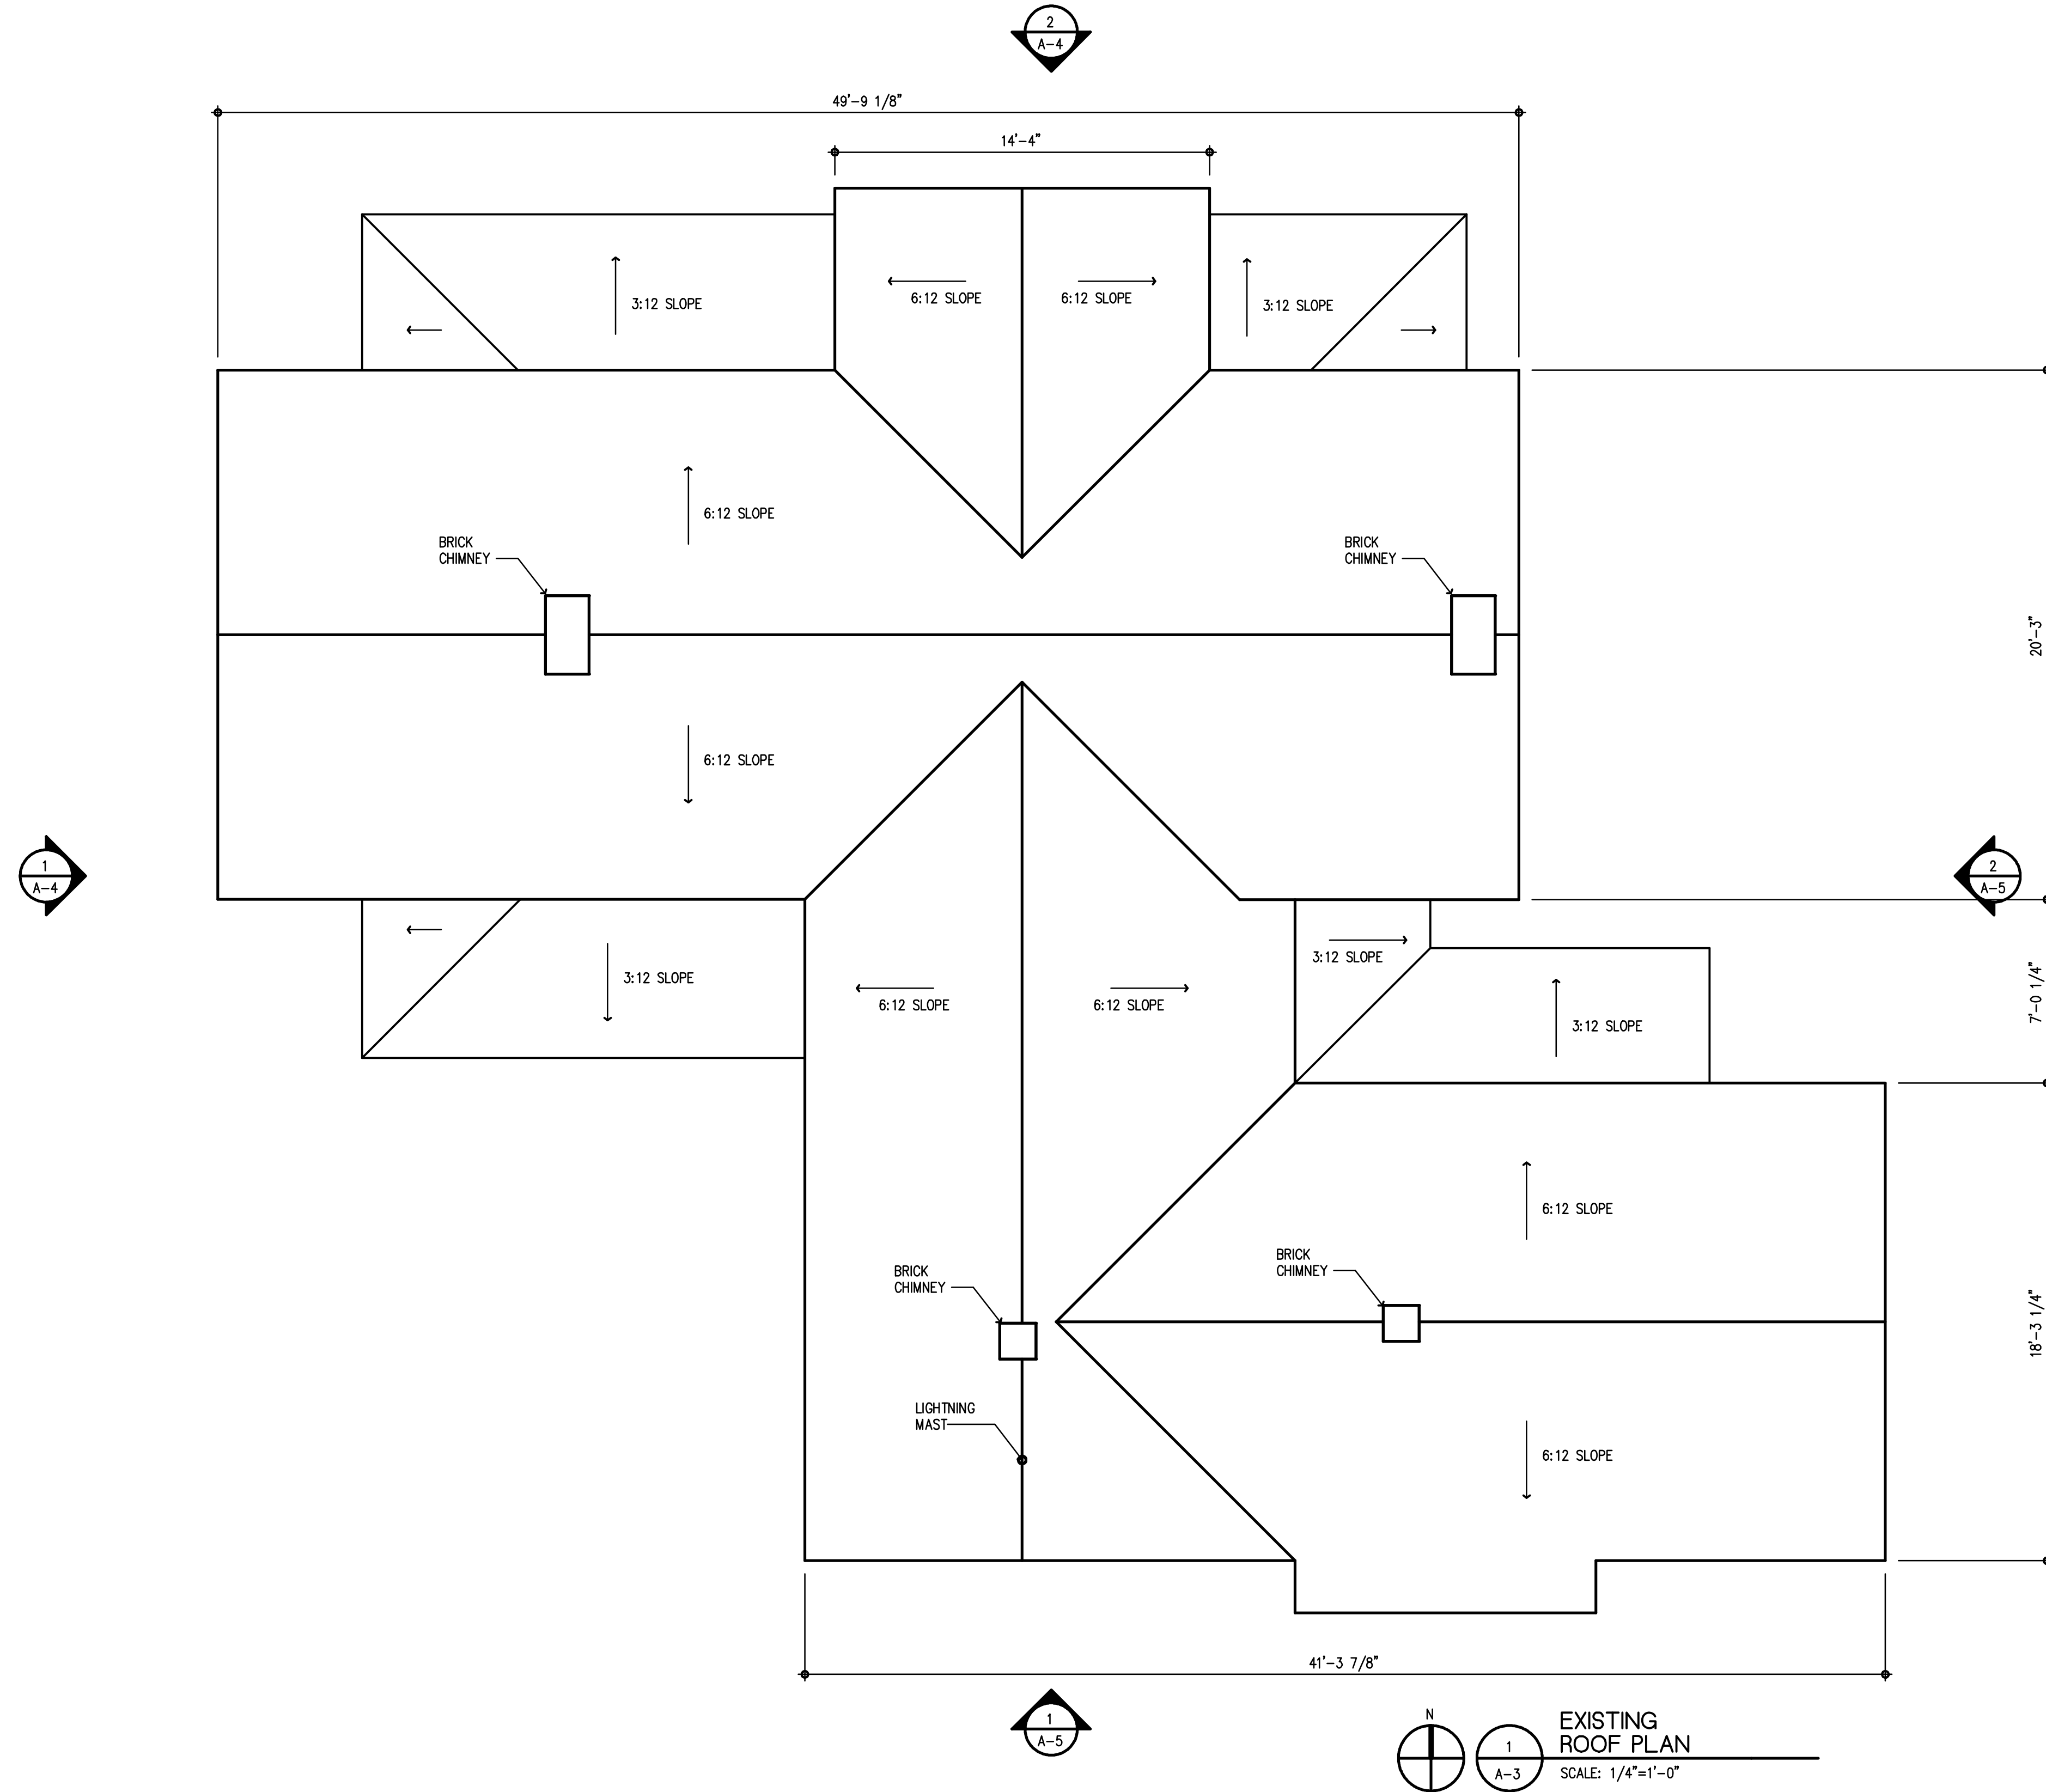

EXISTING
ROOF PLAN
SCALE: 1/4"=1'-0"

H:\2021\2126.03 HV Seven Gables - As-Built\Drawings\2126.03 Seven Gables Elevation Sheet.dwg
2/7/2023 1:40 PM



2
A-4 SOUTHWEST ELEVATION
SCALE: 1/4"=1'-0"



1
A-4 SOUTHEAST ELEVATION
SCALE: 1/4"=1'-0"

NOT FOR CONSTRUCTION

As-Built CAD Drawings
HISTORIC HOUSE OF SEVEN GABLES
11909 125th Street North, Largo, Florida 33774
Pinellas County
400 S. Ft. Harrison, Clearwater, Florida 33756


PROJECT NO.: 2126.03
DATE: 01/31/2023
DRAWN BY: PCP
REVISIONS:

SHEET TITLE:

SHEET NO.:

A-4

OF SHEETS

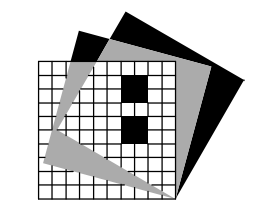

RENKER · EICH · PARKS ARCHITECTS
1609 Dr. Martin Luther King Jr. Street North St. Petersburg, Florida 33704-4203 (727-821-2986)
LIC. AA 0001447

H:\2021\2126.03 HV Seven Gables - As-Built\Drawings\2126.03 Seven Gables Elevation Sheet 2.oec
2/7/2023 1:41 PM



2 NORTHWEST ELEVATION
A-5 SCALE: 1/4"=1'-0"



1 NORTHEAST ELEVATION
A-5 SCALE: 1/4"=1'-0"

NOT FOR CONSTRUCTION

As-Built CAD Drawings
HISTORIC HOUSE OF SEVEN GABLES
11909 125th Street North, Largo, Florida 33774

Pinellas County
400 S. Ft. Harrison, Clearwater, Florida 33756


PROJECT NO.: 2126.03
DATE: 01/31/2023
DRAWN BY: PCP
REVISIONS:

SHEET TITLE:

SHEET NO.:

A-5

OF SHEETS

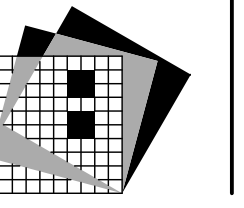

RENKER · EICH · PARKS ARCHITECTS
1609 Dr. Martin Luther King Jr. Street North • St. Petersburg, Florida • 33704-4203 • (727-881-2986)
LIC. AA 0001447